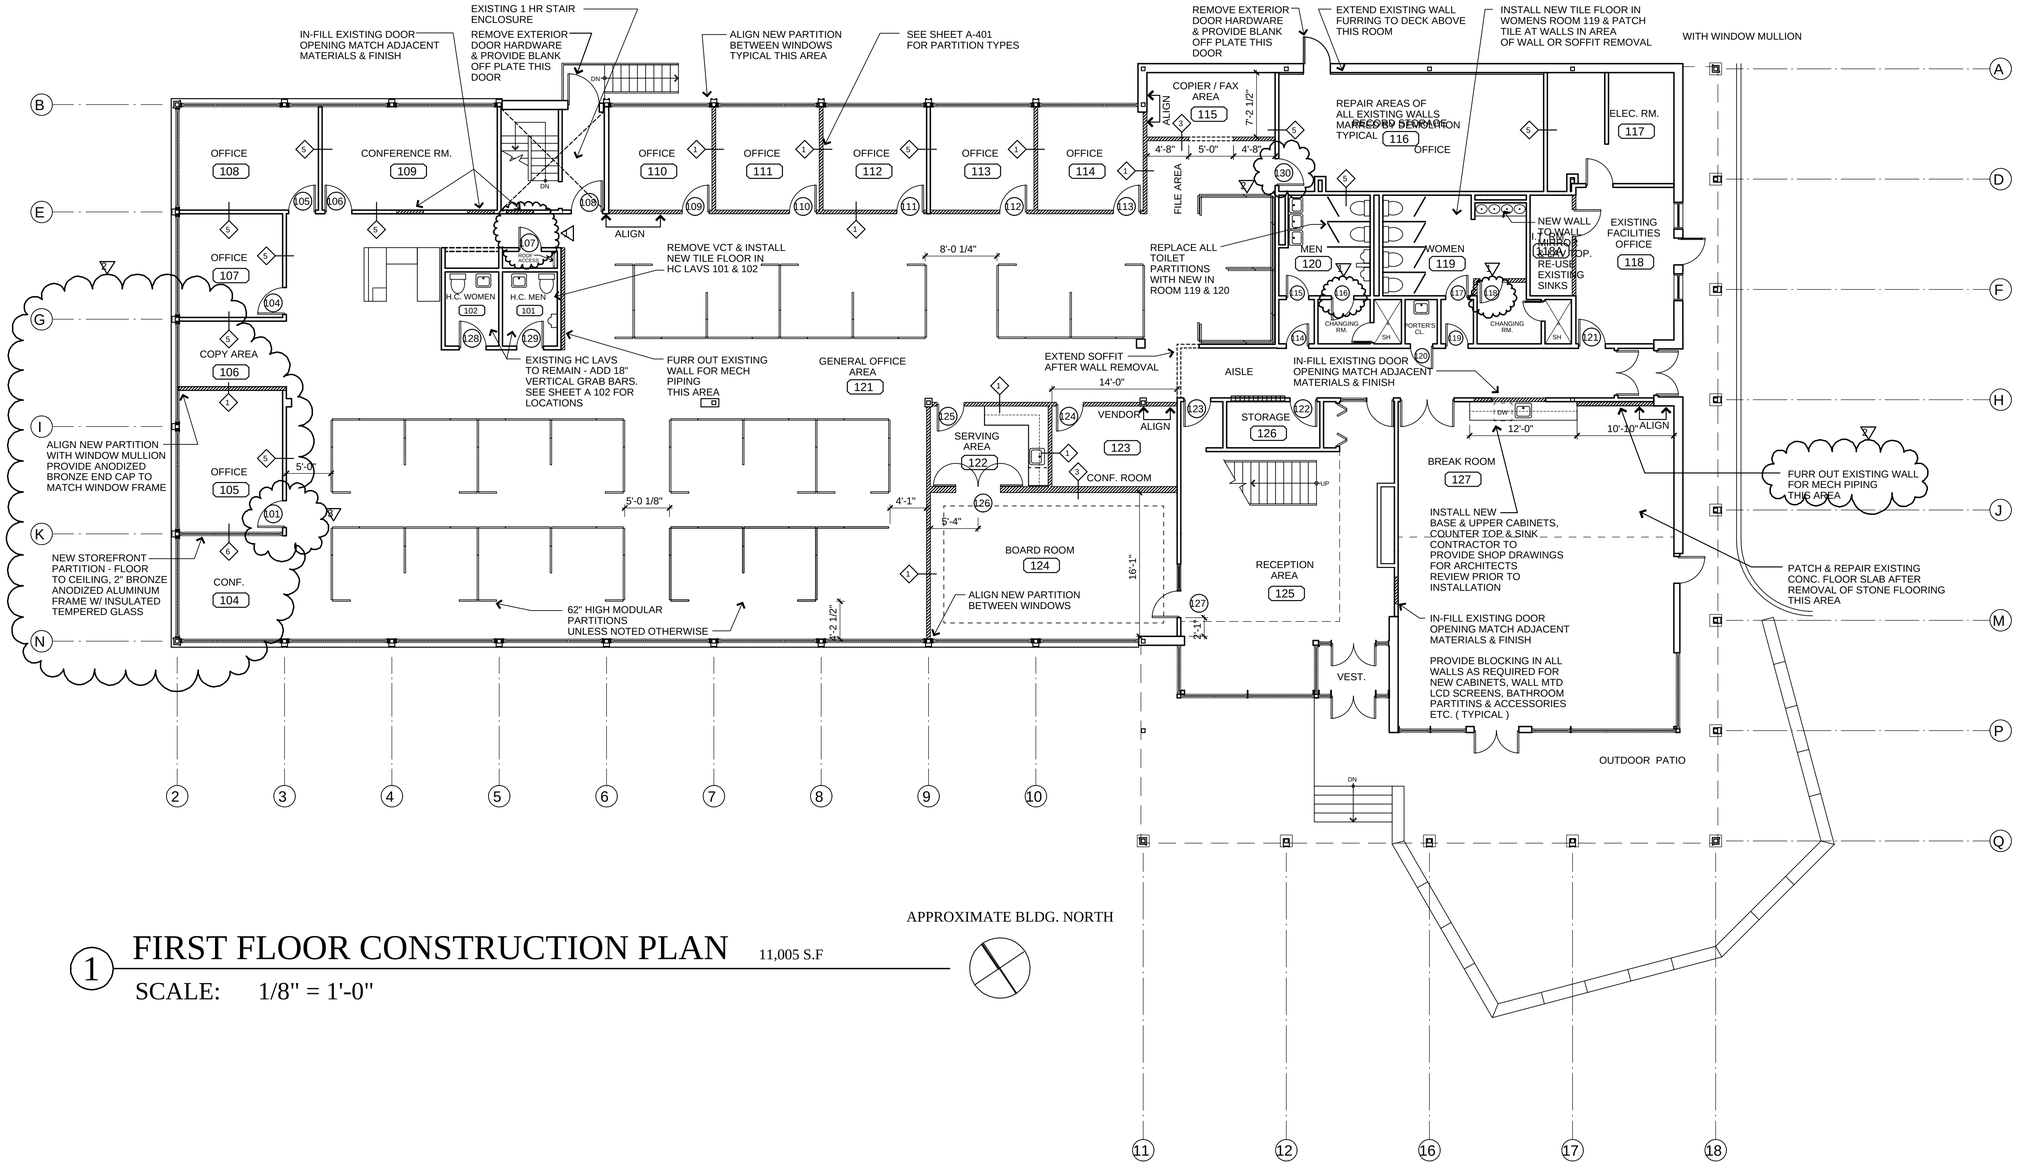

APPROXIMATE BLDG. NORTH

1 FIRST FLOOR CONSTRUCTION PLAN

11,005 S.F

SCALE: 1/8" = 1'-0"

CONSTRUCTION NOTES:

1. CONTRACTOR TO PROVIDE DUSTPROOF PARTITION AS REQ'D DURING DEMOLITION AND CONSTRUCTION WORK.
2. PATCH EXISTING WALLS AS NEEDED FOLLOWING COMPLETION OF DEMOLITION WORK.
3. ALL DIMENSIONS FOR NEW CONSTRUCTION ARE TO FACE OF STUD. CONTRACTOR TO VERIFY ALL DIMENSIONS IN FIELD.
4. ALL NEW GYPSUM BOARD PARTITIONS IN AREA OF CONSTRUCTION ARE TO RECEIVE ONE (1) COAT PRIMER AND TWO (2) COATS FINISH PAINT. ALL EXISTING PARTITIONS TO RECEIVE (2) COATS OF FINISH PAINT.
5. ALL PATCHED AREAS OF GYPSUM BOARD PARTITIONS SHALL HAVE NEW VINYL BASE. SEE INTERIOE DESIGN DRAWINGS.
6. SEE REFLECTED CEILING PLAN FOR CEILING INFORMATION
7. PATCH AND REPAIR EXISTING FLOORS DAMAGED DURING DEMOLITION OR CONSTRUCTION. MATCH ADJACENT MATERIALS AND FINISH.
8. PATCH MARRED AREAS OF EXISTING SLAB TO LEVEL FOR INSTALLATION OF NEW FLOORING.
9. CONTRACTOR TO COORDINATE ALL FRAMING WITH MECHANICAL, ELECTRICAL AND PLUMBING CONTRACTORS.

LEGEND

- EXISTING CONSTRUCTION
- NEW CONSTRUCTION SEE SHEET A410 FOR WALL TYPES
- NEW DOOR & FRAME
- EXISTING DOOR & FRAME

02-15-08 - AS BUILT PLAN

H & R DESIGN
FACILITIES PLANNERS
DESIGN
INTERIORS
PLANNING
50 OSBORNE ST., DANBURY, CT.
phone: 203.790.9750 fax: 203.790.6953

OFFICE

BIODEL CORPORATION

100 SAW MILL ROAD
DANBURY, CONNECTICUT

INTERIOR ALTERATION

CORPORATE RELOCATION
100 SAW MILL ROAD

Date:	7-10-07	Drawn By:	RW
Scale:	AS NOTED	Approved By:	
Job No:	07/042	CAD Ref:	biodelsawml.db

Drawing Title:

FIRST FLOOR CONSTRUCTION PLAN

COPYRIGHT:
H & R Design expressly reserves the common law copyright and other property rights in these plans. These plans are not to be reproduced in any form or manner, nor are they to be assigned to any third party, without first obtaining the expressed written permission and consent of the office of H & R Design. Drawings shall not be scaled for dimensions. Any discrepancies found in these plans, dimensions, existing conditions or any appearent error in classifying or specifing any product material or method of assembly is to be pointed out to the Architect immediately.

Revisions:

7-10-07
GENERAL OFFICE AREA

7-30-07
DOOR SWINGS #116 & 118
DOOR # 107 REVISED
CONST. NOTES

8-10-07 OFFICE & DOOR LOCATIONS & NOTES

8-13-07 DOOR LOCATION

Drawing Number:

A101